

LAND RECLAMATION COMMISSION

STATE OF MISSOURI

P.O. BOX 176

JEFFERSON CITY, MISSOURI 65102

573-751-4041

Permit To Engage in Surface Mining

LAND RECLAMATION COMMISSION

ISSUES TO

PAUL CAMDEN EXCAVATING

Pursuant to "The Land Reclamation Act," RSMo, 2001, and on conformity with the statements

In the application, a permit is hereby granted to engage in surface mining of

sand & gravel in the state of Missouri. The extent of the


Proposed mining operation(s) will be on one acres, more or less.

The locations of the operation(s) under this permit is/are as follows: **Renewal**

County	Section	Township	Range	Acres Renewed	Acres New	Total Acres	Site/Stream Name	Site Number
Dent	33	34N	04W	1	0	1	Stone Hill Creek	1842


This permit may be suspended or revoked upon violation of any or all of the conditions set forth in "The Land Reclamation Act," RSMo. 2001, or in such rules and regulations as are promulgated pursuant thereto by the Land Reclamation Commission.

IN WITNESS WHEREOF I have hereunto set my hand this 14th day of May 2004

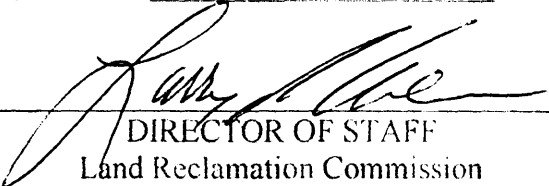
DIRECTOR OF STAFF
Land Reclamation Commission

Permit No. 0876
Effective Date 05/14/2004
Expiration Date 05/06/2005

MO 780-1122 (6-95)

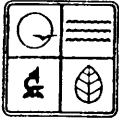

MISSOURI DEPARTMENT OF NATURAL RESOURCES
LAND RECLAMATION COMMISSION
PERMIT RENEWAL FOR INDUSTRIAL MINERAL MINES

RECEIVED

MAR 25 2004

P.O. BOX 176
JEFFERSON CITY, MO 65102-0176

NAME OF CORPORATION, COMPANY, PARTNERSHIP OR INDIVIDUAL Paul Camden Excavating, Inc.		MISSOURI LAND RECLAMATION COMMISSION		3/22/2004	
ADDRESS P O Box 484		CITY Salem	STATE MO	ZIP CODE 65560	
CONTACT PERSON PAUL CAMDEN			TELEPHONE NUMBER 573-729-7359		

FEES: COMPLETE SECTION I OR SECTION II

SECTION I. Fees: Open pit operators and those mining more than 5,000 tons of sand and/or gravel:

1. To compute the site fee complete the information below:

SITE NAME OR NUMBER (add a separate sheet for additional sites)	Mark each month that the site will be operated during the permit year	For sites operated less than six months per permit year pay \$150 For sites operated six months or more per permit year pay \$300
1. Stone Hill Creek #1842	Jan, Feb, Mar, Apr, May, Jun, Jul, Aug, Sep, Oct, Nov, Dec	\$ 300.00
2.	Jan, Feb, Mar, Apr, May, Jun, Jul, Aug, Sep, Oct, Nov, Dec	\$
3.	Jan, Feb, Mar, Apr, May, Jun, Jul, Aug, Sep, Oct, Nov, Dec	\$
4.	Jan, Feb, Mar, Apr, May, Jun, Jul, Aug, Sep, Oct, Nov, Dec	\$
5.	Jan, Feb, Mar, Apr, May, Jun, Jul, Aug, Sep, Oct, Nov, Dec	\$
6.	Jan, Feb, Mar, Apr, May, Jun, Jul, Aug, Sep, Oct, Nov, Dec	\$
7.	Jan, Feb, Mar, Apr, May, Jun, Jul, Aug, Sep, Oct, Nov, Dec	\$
8.	Jan, Feb, Mar, Apr, May, Jun, Jul, Aug, Sep, Oct, Nov, Dec	\$
9.	Jan, Feb, Mar, Apr, May, Jun, Jul, Aug, Sep, Oct, Nov, Dec	\$
10.	Jan, Feb, Mar, Apr, May, Jun, Jul, Aug, Sep, Oct, Nov, Dec	\$
TOTAL SITE FEE		\$

2. Acreage Fee \$5 X _____ number of acres bonded\$

3. Annual Permit Fee\$ 500

4. Total Fee (Add totals from 1, 2 and 3)\$

NOTE: If Total Fee exceeds \$2,500.00 then pay only\$ 2,500

SECTION II. FEES: Sand or gravel operators mining less than 5,000 tons per year:

1. Annual Permit Fee\$ 300

SIGNATURE OF APPLICANT <i>Paul Camden</i>	TITLE President	DATE 3/23/2004
--	---------------------------	--------------------------

Appeared before me this 23 day of MARCH, 2004,
to me personally known, who executed the above as their free acts and deeds.

NOTARY PUBLIC EMBOSSER SEAL	STATE OF MISSOURI	COUNTY (OR CITY OF ST. LOUIS) DENT
	SUBSCRIBED AND SWORN BEFORE ME, THIS 23rd DAY OF March YEAR 2004	
	NOTARY PUBLIC SIGNATURE <i>Shirley Camden</i>	MY COMMISSION EXPIRES 11/3/07
	NOTARY PUBLIC NAME (TYPED OR PRINTED) SHIRLEY CAMDEN	

USE RUBBER STAMP IN CLEAR AREA BELOW.

SHIRLEY CAMDEN
Notary Public-Notary Seal
State of Missouri
Dent County
My Commission Expires Nov 3, 2003

FOR DEPARTMENT USE ONLY: APPROVED BY <i>[Signature]</i>	DATE APPROVED 3-26-04	PERMIT NUMBER 0876	EXPIRATION DATE 5-6-05
--	---------------------------------	------------------------------	----------------------------------



MISSOURI DEPARTMENT OF NATURAL RESOURCES
LAND RECLAMATION COMMISSION
SITE INFORMATION FORM

To be completed for each separate area of disturbance associated with mining operations.		
SITE NAME OR NUMBER Meramec River <i>Stone Hill Creek</i>		PERMIT NUMBER <i>0876</i>
COMPANY NAME <i>Paul Camden Excavating</i>		
COUNTY <i>Dent</i>	1/4 SECTION <i>S-E</i>	SECTION 34 <i>33</i>
TOWNSHIP <i>34 N</i>	RANGE <i>4 W</i>	ACRES <i>1</i>
RIVER OR STREAM NAME (FOR IN-STREAM ACRES) Meramec River <i>Stone Hill Creek</i>		
MINERAL COMMODITY <i>Sand and Gravel</i>		ESTIMATED TONS/YEAR (FOR GRAVEL SITES) <i>Less than 5000 tons per year</i>

NAME OF LANDOWNER (ATTACH LIST IF MORE THAN ONE) <i>Winfred Parker</i>		
ADDRESS <i>Bixby Route</i>		
CITY <i>Salem</i>	STATE <i>MO</i>	ZIP CODE <i>65560</i>
SOURCE OF RIGHT TO MINE (CHECK ONE): <input type="checkbox"/> MINERAL DEED <input type="checkbox"/> WARRANTY DEED <input type="checkbox"/> OTHER (DESCRIBE): _____		DATE OF AGREEMENT <i>2/12/2001</i>
<input type="checkbox"/> LEASE <input checked="" type="checkbox"/> VERBAL AGREEMENT		

MINERAL RIGHTS OWNER (ATTACH LIST IF MORE THAN ONE) <i>Same as above</i>		
ADDRESS		
CITY	STATE	ZIP CODE
SOURCE OF RIGHT TO MINE (CHECK ONE): <input type="checkbox"/> MINERAL DEED <input type="checkbox"/> WARRANTY DEED <input type="checkbox"/> OTHER (DESCRIBE): _____		DATE OF AGREEMENT
<input type="checkbox"/> LEASE <input type="checkbox"/> VERBAL AGREEMENT		

NOTE: Each site must be shown on a map and be included in a public notice and an approved mine plan.



MISSOURI DEPARTMENT OF NATURAL RESOURCES
LAND RECLAMATION COMMISSION

PERMIT APPLICATION FOR INDUSTRIAL MINERAL MINES

RECEIVED

FEB 20 2001

P.O. BOX 176
JEFFERSON CITY, MO 65102

NAME OF CORPORATION, COMPANY, PARTNERSHIP OR INDIVIDUAL Paul Camden Excavating		DATE 2/12/2001	
ADDRESS P O Box 484	CITY Salem	STATE MO	ZIP CODE 65560
CONTACT PERSON Paul Camden		TELEPHONE NUMBER (573) 729-7359	

Check any that apply:

☒ New Permit ☐ Permit Renewal ☐ Permit Amendment ☐ Permit Revision ☐ Permit Expansion

SITE NAME OR NUMBER	ACRES TO BE PERMITTED		TOTAL ACRES FOR ALL SITES
	INSTREAM	ALL OTHER	
Meramec River Stone Hill Creek	1 (new)		1

Fees - Complete A or B

A - For sand and gravel operators mining less than 5,000 tons/year
Permit Fee \$100.00
Number of new acres 1 X \$35.00/acre \$ 35.00

B - For ALL other operations
Permit Fee \$350.00
Number of sites X \$40.00/site \$
Number of new acres X \$35.00/acre \$

Total fees \$ 135.00

Bonding for all acreage EXCEPT instream - Complete A or B

A - For sand and gravel operators mining less than 5,000 tons/year
Number of new acres X \$500.00/acre ... \$ N/A

B - For ALL other open pit operations
Minimum per permit \$ 8,000.00
Acreage over 8 acres X \$500.00/acre \$
Number of new acres where topsoil will be sold
or discarded X \$4,500.00/acre \$
Total bonding required \$

☐ Check here if adequate bonding is already posted.

List all other Land Reclamation Commission permits previously or currently held by applicant or by companies owned or partially controlled by applicant. If none, write "none" below.

NAME OF COMPANY	PERMIT NUMBER	MINERAL COMMODITY	YEARS
None			

For any of the above which have been served Cessation of Operations or Bond Forfeiture, or have unabated Notices of Violation, please give:

PERMIT NUMBER	TYPE OF ACTION
None	

I certify that all statements made on this application are correct, complete, and true, to the best of my knowledge.

SIGNATURE OF APPLICANT <i>Paul Camden</i>	TITLE Owner	DATE 2/12/2001
--	----------------	-------------------

Appeared before me this 12th day of February, ~~xx~~ 2001, Paul Camden to me personally known, who executed the above as their free acts and deeds.

NOTARY PUBLIC EMBOSSER SEAL	STATE Missouri	COUNTY (OR CITY OF ST. LOUIS) Dent
	SUBSCRIBED AND SWORN BEFORE ME THIS <u>12th</u> DAY OF <u>February</u> , <u>2001</u>	
	NOTARY PUBLIC SIGNATURE <i>Shirley Camden</i>	MY COMMISSION EXPIRES <u>11/3/2003</u>
	NOTARY PUBLIC NAME (TYPED OR PRINTED) Shirley Camden	

APPROVED BY (DIRECTOR'S REPRESENTATIVE) <i>Jim [Signature]</i>	DATE APPROVED 4-9-01	PERMIT NUMBER 0876	EXPIRATION DATE 5-6-2002
---	-------------------------	-----------------------	-----------------------------



MISSOURI DEPARTMENT OF NATURAL RESOURCES
LAND RECLAMATION COMMISSION

STREAM PROTECTION PLAN - 10 CSR 40-10.020(2)(D)3

(Required for in-stream sites, or as required by the Director)

RECEIVED

FEB 20 2001

MISSOURI LAND

RECLAMATION COMMISSION

TYPE OF PLAN
(CHECK ONE):

☐ SHORT TERM, FOR ONE PERMIT YEAR

☒ LONG TERM, FOR PERIOD THROUGH DATE:

March ^{April}
2006 ²⁰¹¹

Company Name: Paul Camden Excavating

DESCRIPTION OF STREAM CONDITION PRIOR TO LAND RECLAMATION COMMISSION PERMITTING (BY APPLICANT OR PRIOR OPERATOR), INCLUDING BANK CONDITION, BANK VEGETATION AND WATER QUALITY.

stone Hill
creek

The area to be mined involves a 1/2 mile stretch of ~~Meramec River~~ south of County Road 522. This section of the creek is bordered by agricultural operations (Pasture). One side of the river has a low sloping bank. The opposite side is steep.

(Map enclosed)

DESCRIBE METHODS USED TO REDUCE DAMAGE TO STREAM BANKS, SUCH AS PROTECTING BANK VEGETATION, IF APPLICABLE.

No vegetation on banks will be disturbed.
Stream banks will not be changed.

A ten foot buffer zone will be maintained between
the excavation and the stream banks 114-6-01

DESCRIBE METHODS USED TO REDUCE DAMAGE TO STREAM ENVIRONMENTS, SUCH AS KEEPING ACTIVE MINING OPERATIONS ON GRAVEL BARS, RATHER THAN IN FLOWING WATER, AND KEEPING HAUL ROADS AWAY FROM FLOWING WATER, IF APPLICABLE.

Gravel removal will be restricted to the exposed portions of gravel (gravel bars). We will shave the tops of the gravel bars to a depth no deeper than the normal water level. This will avoid causing erosion of the streambank and channel at the mining site and upstream (head-cutting).

Gravel removal will be restricted to periods of low flow.

Access to the gravel bar will be accomplished by using one primary entrance/exit.

By my signature, I attest to the following:

- 1) All statements made on this Mine Plan Form are correct, complete, and true, to the best of my knowledge.
- 2) I or the company I am authorized to represent intend(s) to mine in accordance with this Plan, and in accordance with the Missouri Land Reclamation Act, Sections 444.760 through 444.789, RSMo (Supp. 1990), and all rules, regulations, orders, decisions and permits of the Missouri Land Reclamation Commission pertaining to my company's surface mining operations.
- 3) I have a valid agreement with all landowners which gives me the right to grant access to the Director of the Missouri Land Reclamation Commission and his authorized representatives, and I grant such access, and further where I have no right to grant such access, I have attached signed affidavits from the landowners granting such access.

SIGNATURE OF APPLICANT ▶ <i>Paul Camden</i>	TITLE Owner	DATE 2/12/2001
--	----------------	-------------------

Appeared before me this 12th day of February, ~~xxx~~ 2001.

Paul Camden to me personally known,

who executed the above as their free acts and deeds.

NOTARY PUBLIC EMBOSSER SEAL	STATE OF <u>Missouri</u>	COUNTY (OR CITY OF ST. LOUIS) <u>Dent</u>
	SUBSCRIBED AND SWORN BEFORE ME, THIS <u>2001</u> <u>12th</u> DAY OF <u>February</u> 19x	
	NOTARY PUBLIC SIGNATURE <i>Shirley Camden</i>	MY COMMISSION EXPIRES <u>11/3/2001</u>
	NOTARY PUBLIC NAME (TYPED OR PRINTED) <u>Shirley Camden</u>	

USE RUBBER STAMP IN CLEAR AREA BELOW.

APPROVED BY (DIRECTOR'S REPRESENTATIVE) ▶ <i>Tim Zha</i>	TITLE <u>4 LRS II</u>	DATE APPROVED <u>4-9-01</u>
---	--------------------------	--------------------------------


Locator Map

Paul Camden Excavating
Dent Co

S-33, T-34N, R-04W

4-6-01


Stone Hill Creek

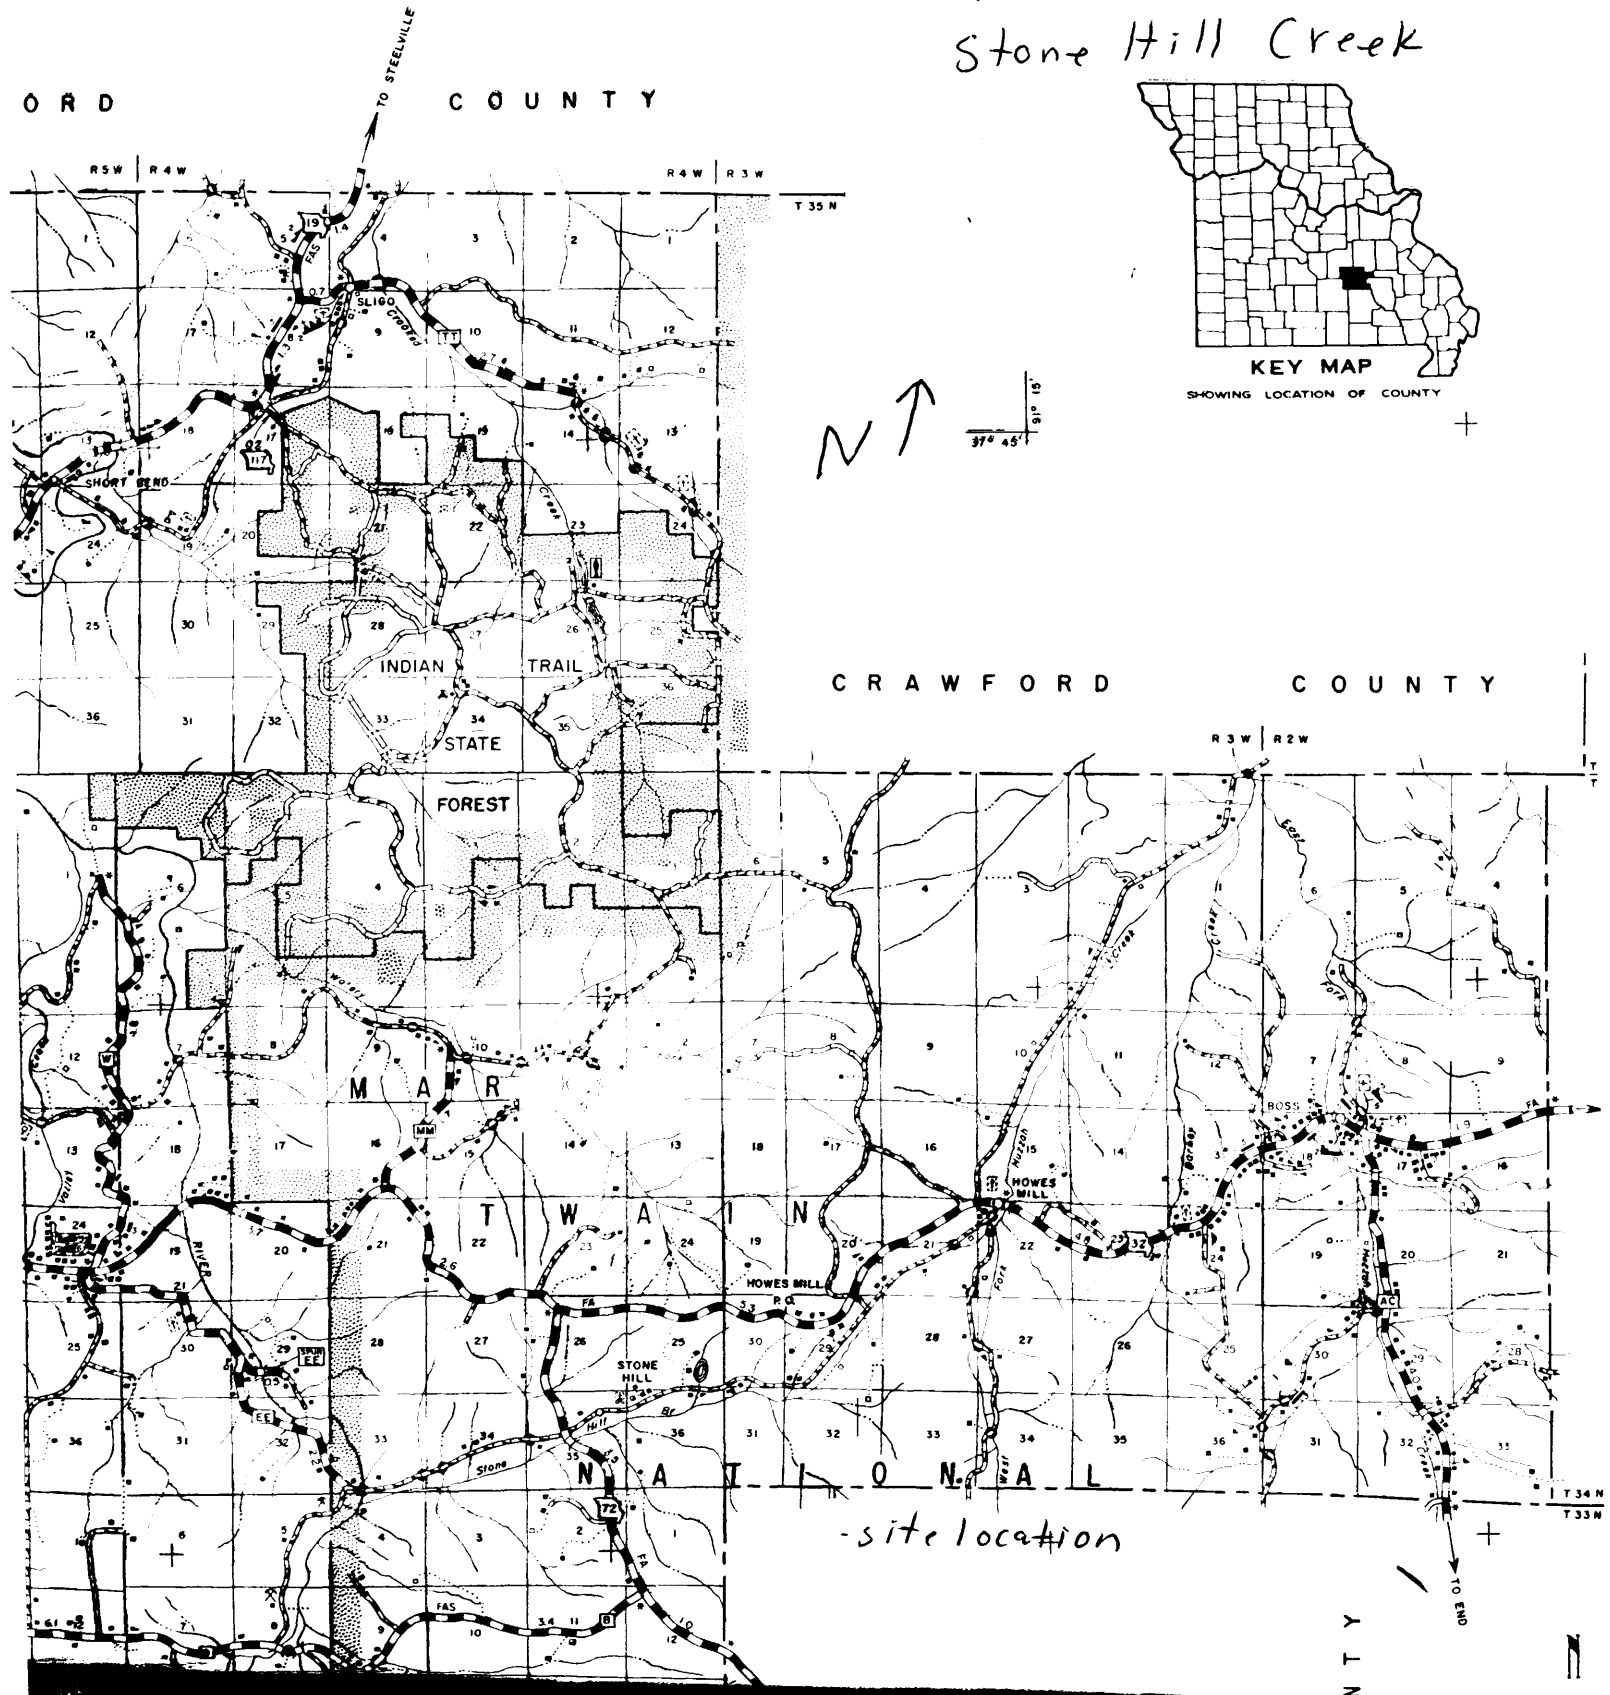

-site location

7-181-91-1

RECEIVED
APR 05 2001
MISSOURI LAND
RECLAMATION COMMISSION

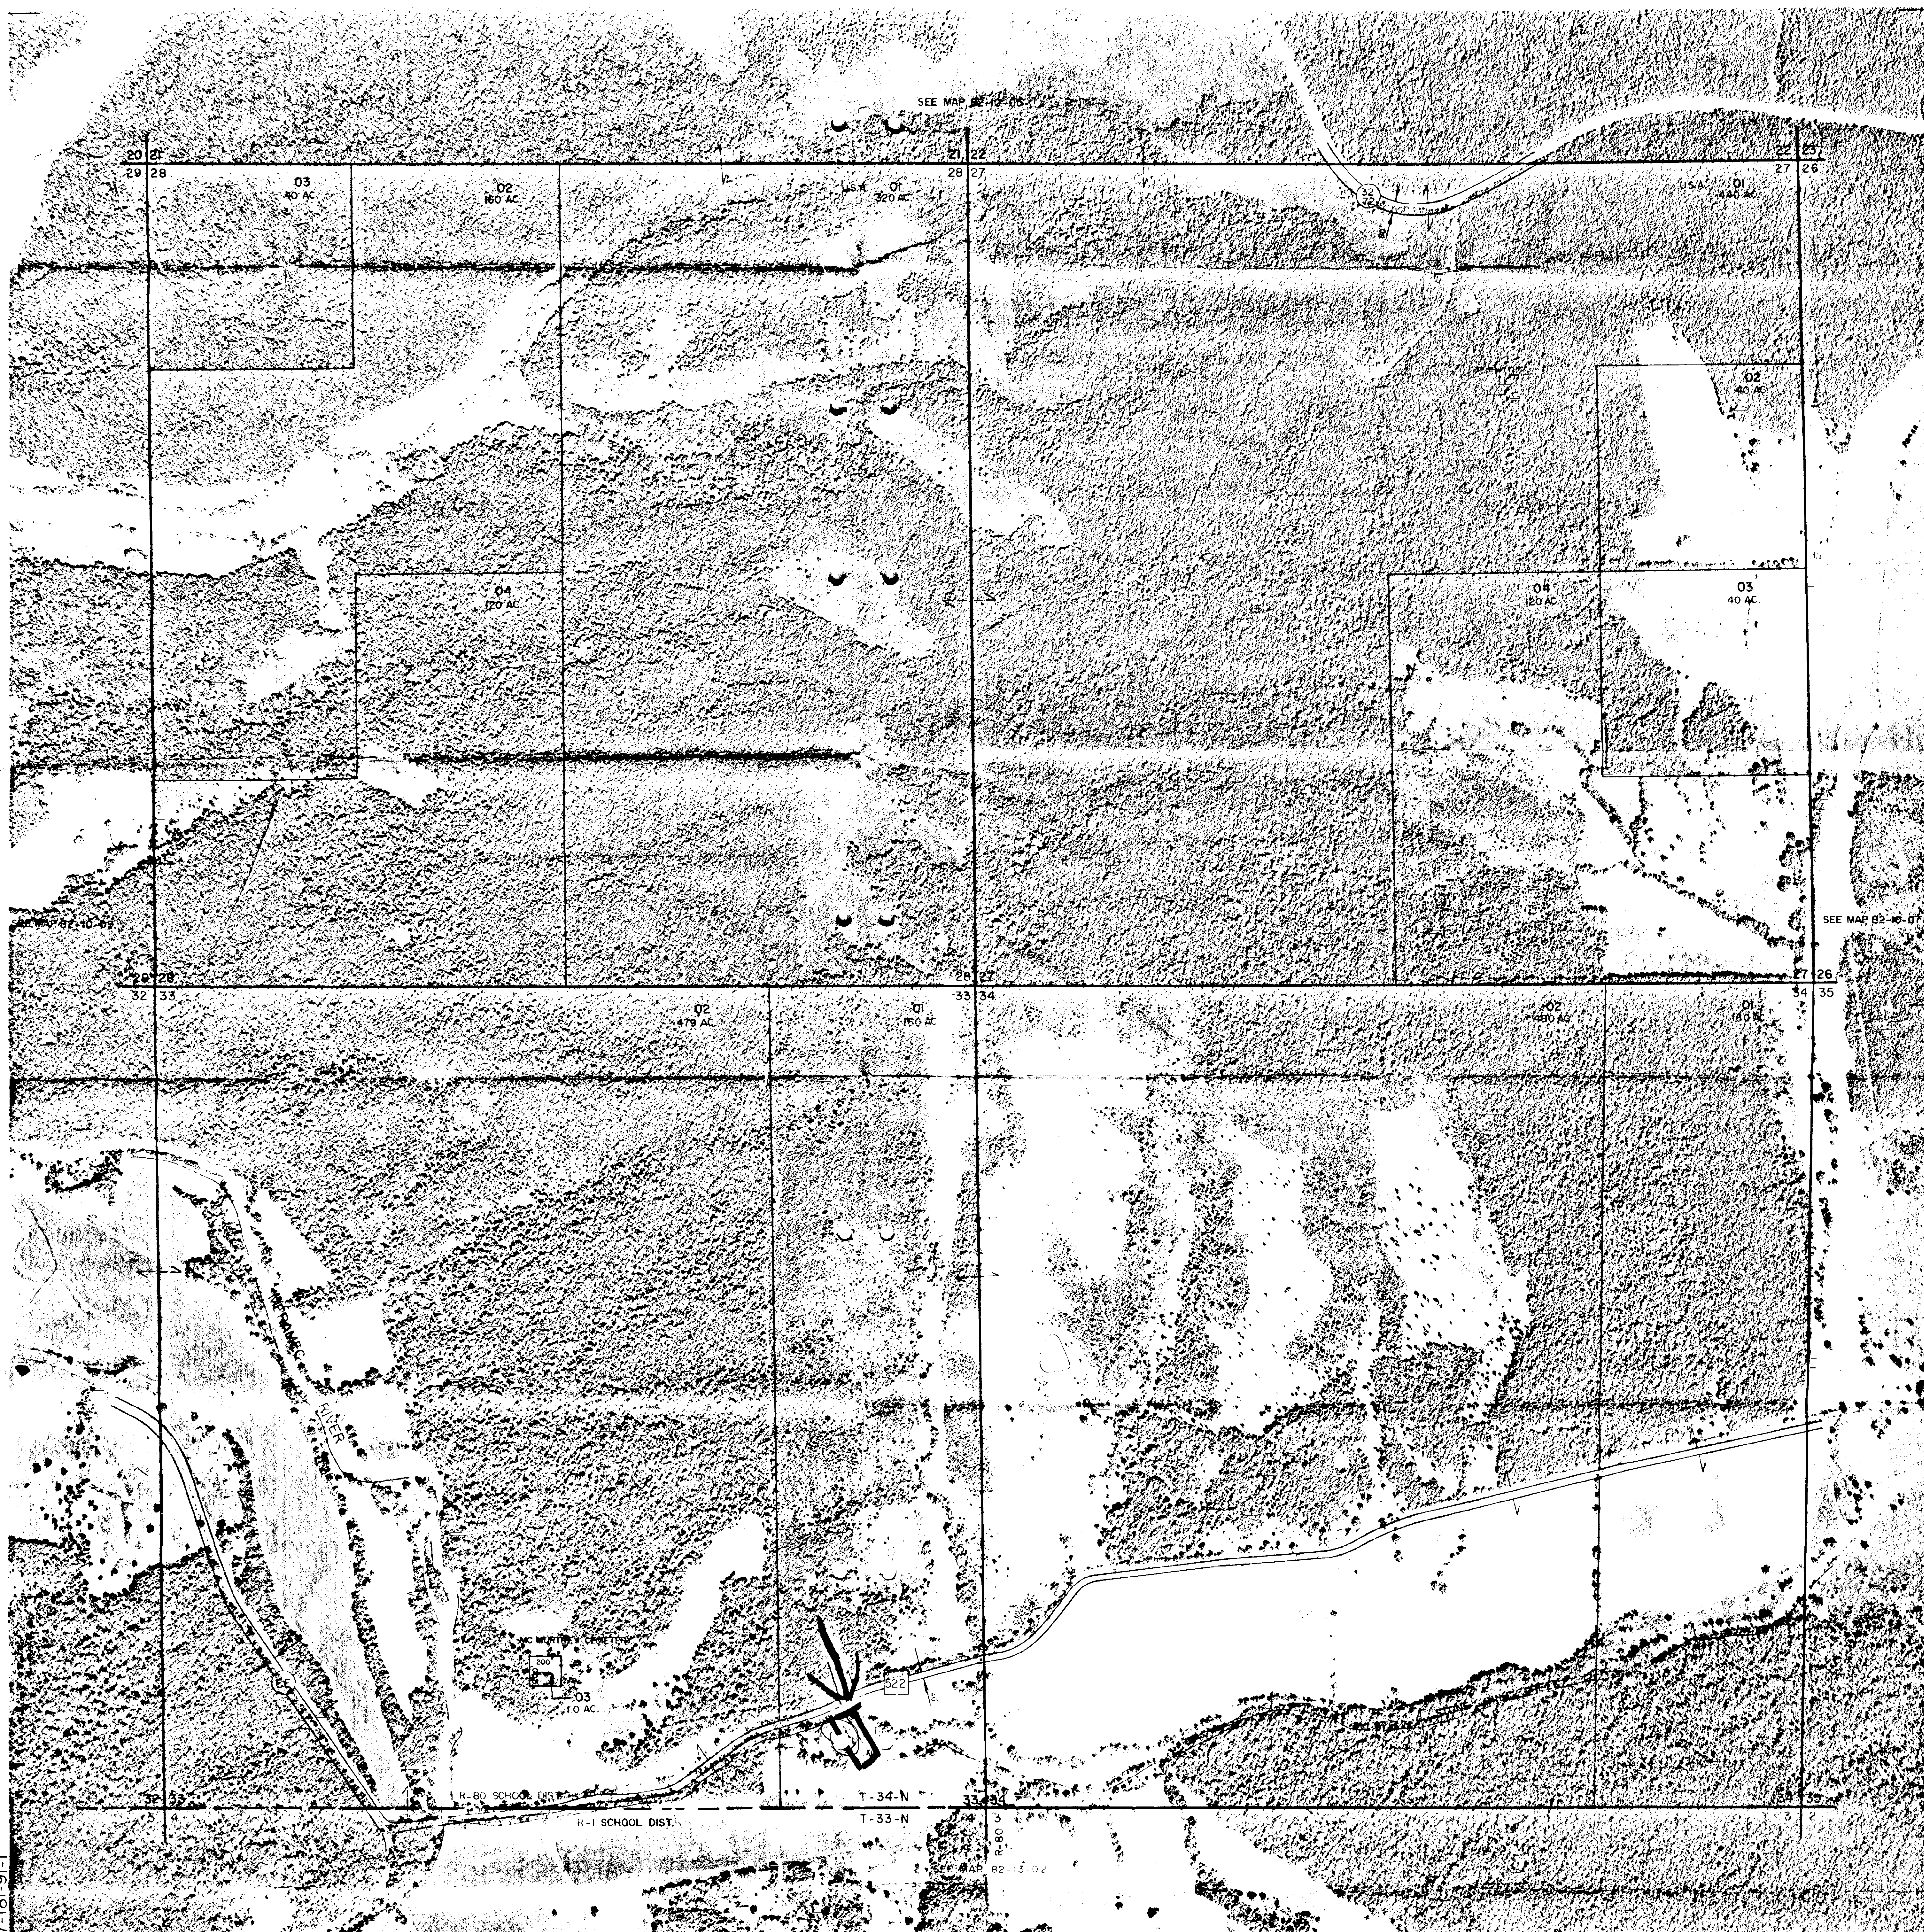

Detail Map 4-9-01
Paul Camden Excavating - Permit # 0876
Dent Co.
S-33, T-34N, R-4W
- Gravel Bar Location - Stone Hill Creek
1" = 400'

82-10-08

A